

APPLICATION FOR PERMIT
COUNTY OF LOS ANGELES
DEPARTMENT OF COUNTY ENGINEER
BUILDING AND SAFETY DIVISION
JOHN A. LAMBIE, County Engineer
WILLIAM A. JENSEN, Sup't of Building

SEWER-SEWAGE DISPOSAL

1

FOR APPLICANT TO FILL IN W 93'

LEGAL DESCRIPTION LOT NO. **N 35' 95.75 9 LOT 7**
BLOCK TRACT **3239**
SIZE OF LOT **35x93** NO. OF BLDGS. NOW ON LOT
USE OF BUILDINGS

CONTRACTOR **CHAS. O. HARRIS**
ADDRESS **1931 DEL PASO AVE**
CITY **LA** TEL. NO. **CA 18729**

REGISTRATION NO.		STATE COUNTY	
NO.	DESCRIPTION OF WORK	FEE	
	HOUSE SEWER CONNECTING TO PUBLIC SEWER	@ \$5.00	
	SEPTIC TANK, SEEPAGE PIT OR PITS AND/OR DRAINFIELD	@ \$10.00	
	HOUSE SEWER CONNECTING TO PRIVATE DISPOSAL SYSTEM	@ \$3.00	
	CONNECT ADDITIONAL BLDG. OR WORK TO HOUSE SEWER	@ \$3.00	
	OVERFLOW SEEPAGE PIT, DRAINFIELD EXTN., CESSPOOL, DRYWELL, MANHOLE	@ \$5.00	
	ALTER, REPAIR OR ABANDON HOUSE SEWER OR DISPOSAL SYSTEM	@ \$3.00	3.00

OWNER'S AUTHORIZATION
PERMIT \$ **2.00**
TOTAL FEE **5.00**

I HAVE AT THIS DATE A CONTRACT WITH THE HEREIN NAMED CONTRACTOR TO CONNECT THE ABOVE DESCRIBED EXISTING DWELLING TO THE PUBLIC SEWER.

SIGNED THIS _____ DAY OF _____ 19____

OWNER OR OWNERS AGENT _____

ADDRESS _____

I HEREBY ACKNOWLEDGE THAT I HAVE READ THIS APPLICATION AND STATE THAT THE ABOVE IS CORRECT AND AGREE TO COMPLY WITH ALL COUNTY ORDINANCES AND STATE LAWS REGULATING PLUMBING AND SEWERS.

I HEREBY CERTIFY THAT I AM PROPERLY REGISTERED AND/OR LICENSED AS REQUIRED BY LOS ANGELES COUNTY AND STATE OF CALIFORNIA OR THAT I AM THE LEGAL OWNER OF, AND INTEND TO RESIDE IN, THE ABOVE DESCRIBED RESIDENTIAL PROPERTY.

SIGNATURE OF PERMITTEE **Chas O Harris**

BUILDING ADDRESS **21904 So Vermonta**
LOCALITY **CARSON**
NEAREST CROSS ST. **219th St**
OWNER **Chas O HARRIS**
MAIL ADDRESS **1931 DEL PASO AVE**
CITY **LOS ANGELES** TEL. NO. **CA 18729**

DISTRICT NO. **12** GROUP **I** MAP PG **C 149** PROCESSED BY **Erwin**
CONNECTION DATA

STATION DEPTH
MANHOLE REFERENCE UPPER LOWER
Y. TYPE OF CONNECTION CURB P.L. LENGTH FROM M.L. TO P.L.
P.C. NO. JOB NO.
CO. IMP. NO.
TRUNK PERMIT NO. ROAD PERMIT NO.
AFFIDAVIT WAIVER EASEMENT RECORD. INSTR. NO. DATE

HWY. OR ST. WIDENING
STATE ENCROACHMENT PERMIT NO.
INDUSTRIAL WASTE APPROVAL
CHARGES

CONNECTION CHARGE FEE
REIMBURSEMENT FEE

APPROVALS	DATE	INSPECTOR'S SIGNATURE
NEW HOUSE SEWER		
CONNECT ADDITIONAL BUILDING OR WORK		
SEPTIC TANK, SEEP, PIT(S) AND/OR DRAINFIELD		
CESSPOOL <input type="checkbox"/> DRYWELL <input type="checkbox"/>		
ALTER, REPAIR, SEWER OR SEWAGE DISPOSAL SYSTEM	9-2	O. H. Erwin
DISCONNECT PLUG AND ABANDON HOUSE SEWER		
BACKFILL SEPTIC TANKS <input type="checkbox"/> SEEP, PIT(S) <input type="checkbox"/> CESSPOOLS <input type="checkbox"/>		

VALIDATION
CK. M. O. **CASH** **ROBERT A. WOOD**
SUPERVISING MECHANICAL ENGINEER

1066903 SEP 31 0 A 5.00

6418
19
20


E. Erwin

INSPECTOR COPY

FOR DEPARTMENT USE

REQUIRED INFORMATION

1. INDICATE ALL BUILDINGS ON PROPERTY.
2. INDICATE AND DIMENSION SEWAGE DISPOSAL SYSTEM WITH TIE DISTANCES TO BUILDINGS AND PROPERTY LINES.
3. INDICATE SIZE OF SEPTIC TANK—DEPTH OF SEEPAGE PIT(S)—SIZE OF CESSPOOL(S).
4. INDICATE NORTH DIRECTION ON PLOT.
5. INDICATE BOTH STREETS IF CORNER.

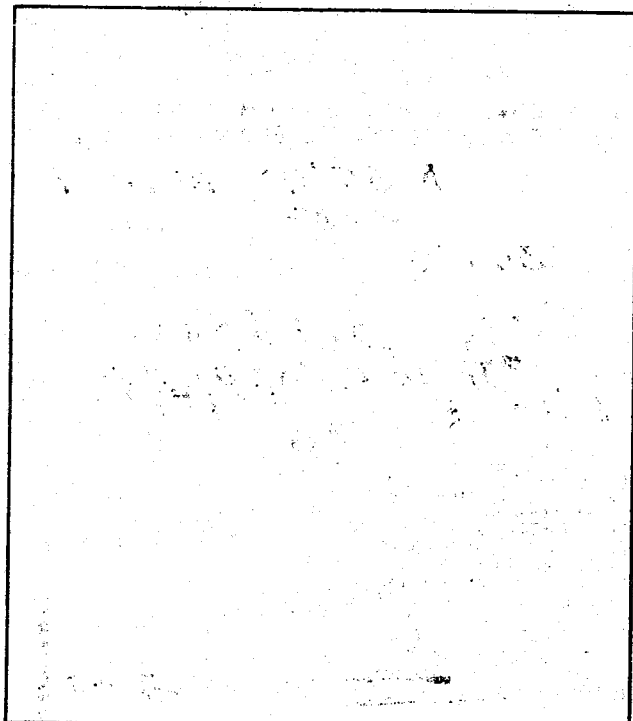

ST. ALLEY R/W

FIELD NOTES

APPLICATION FOR PERMIT
COUNTY OF LOS ANGELES
DEPARTMENT OF COUNTY ENGINEER
BUILDING AND SAFETY DIVISION
JOHN A. LAMBIE, County Engineer
WILLIAM A. JENSEN, Sup't of Building

SEWER-SEWAGE DISPOSAL

1

FOR APPLICANT TO FILL IN w 93'

LEGAL DESCRIPTION LOT NO. **N 35' of S 75' of Lot 7**BLOCK TRACT **3239**SIZE OF LOT **35x93'** NO. OF BLDGS. **1**
NOW ON LOTUSE OF BUILDINGS **PWG**CONTRACTOR **HOFMANN & SON**ADDRESS **4443 W. 161st**CITY **LAWDALE** TEL. NO. **370-1210**REGISTRATION NO. **160808** ☒ STATE COUNTY

NO.	DESCRIPTION OF WORK	FEE	
1	HOUSE SEWER CONNECTING TO PUBLIC SEWER @ \$5.00	5.00	
	SEPTIC TANK, SEEPAGE PIT OR PITS AND/OR DRAINFIELD @ \$10.00		
	HOUSE SEWER CONNECTING TO PRIVATE DISPOSAL SYSTEM @ \$3.00		
	CONNECT ADDITIONAL BLDG. OR WORK TO HOUSE SEWER @ \$3.00		
	OVERFLOW SEEPAGE PIT, DRAINFIELD EXTN., CESSPOOL, DRYWELL, MANHOLE @ \$5.00		
	ALTER, REPAIR OR ABANDON HOUSE SEWER OR DISPOSAL SYSTEM @ \$3.00		

OWNER'S AUTHORIZATION	PERMIT	\$	2.00
	TOTAL FEE		7.00

I HAVE AT THIS DATE A CONTRACT WITH THE HEREIN NAMED CONTRACTOR TO CONNECT THE ABOVE DESCRIBED EXISTING DWELLING TO THE PUBLIC SEWER.

SIGNED THIS _____ DAY OF _____ 19____

OWNER OR OWNERS AGENT _____

ADDRESS _____

I HEREBY ACKNOWLEDGE THAT I HAVE READ THIS APPLICATION AND STATE THAT THE ABOVE IS CORRECT AND AGREE TO COMPLY WITH ALL COUNTY ORDINANCES AND STATE LAWS REGULATING PLUMBING AND SEWERS.

I HEREBY CERTIFY THAT I AM PROPERLY REGISTERED AND/OR LICENSED AS REQUIRED BY LOS ANGELES COUNTY AND STATE OF CALIFORNIA OR THAT I AM THE LEGAL OWNER OF, AND INTEND TO RESIDE IN, THE ABOVE DESCRIBED RESIDENTIAL PROPERTY.

SIGNATURE OF PERMITTEE **Harold E. Hofmann**

BUILDING ADDRESS	21904 S. VERMONT
LOCALITY	CARSON
NEAREST CROSS ST.	219th
OWNER	CHAS. O. HARRIS
MAIL ADDRESS	1931 DEL PASO
CITY	L.A.
TEL. NO.	CA. 18729

DISTRICT NO.	GROUP	BK	MAP	PG	PROCESSED BY
12	I	C	149	Brenneman	

CONNECTION DATA

STATION **10+05** DEPTH **7'**MANHOLE REFERENCE **45' N of** **UPPER**TYPE OF CONNECTION CURB **P.L.** LENGTH FROM M.L. TO P.L. **20'**CO. IMP. NO. **1526** P.C. NO. **90148** JOB NO.

TRUNK PERMIT NO. ROAD PERMIT NO.

AFFIDAVIT WAIVER EASEMENT RECORD. INSTR. NO. DATE

HWY. OR ST. WIDENING **10' FUTURE**

STATE ENCROACHMENT PERMIT NO.

INDUSTRIAL WASTE APPROVAL

CHARGES

CONNECTION CHARGE FEE

REIMBURSEMENT FEE

APPROVALS	DATE	INSPECTOR'S SIGNATURE
NEW HOUSE SEWER	9-24	Deturk
CONNECT ADDITIONAL BUILDING OR WORK		
SEPTIC TANK, SEEP. PIT(S) AND/OR DRAINFIELD		
CESSPOOL <input type="checkbox"/> DRYWELL <input type="checkbox"/>		
ALTER, REPAIR, SEWER OR SEWAGE DISPOSAL SYSTEM		
DISCONNECT PLUG AND ABANDON HOUSE SEWER		
BACKFILL SEPTIC TANKS <input type="checkbox"/> SEEP. PIT(S) <input type="checkbox"/> CESSPOOLS <input type="checkbox"/>		

VALIDATION

CK. M. O. CASH

ROBERT A. WOOD
SUPERVISING MECHANICAL ENGINEER

1664183 SEP 11 0 A 7.00


INSPECTOR COPY

New

FOR DEPARTMENT USE

REQUIRED INFORMATION

1. INDICATE ALL BUILDINGS ON PROPERTY.
2. INDICATE AND DIMENSION SEWAGE DISPOSAL SYSTEM WITH TIE DISTANCES TO BUILDINGS AND PROPERTY LINES.
3. INDICATE SIZE OF SEPTIC TANK—DEPTH OF SEEPAGE PIT(S)—SIZE OF CESSPOOL(S).
4. INDICATE NORTH DIRECTION ON PLOT.
5. INDICATE BOTH STREETS IF CORNER.

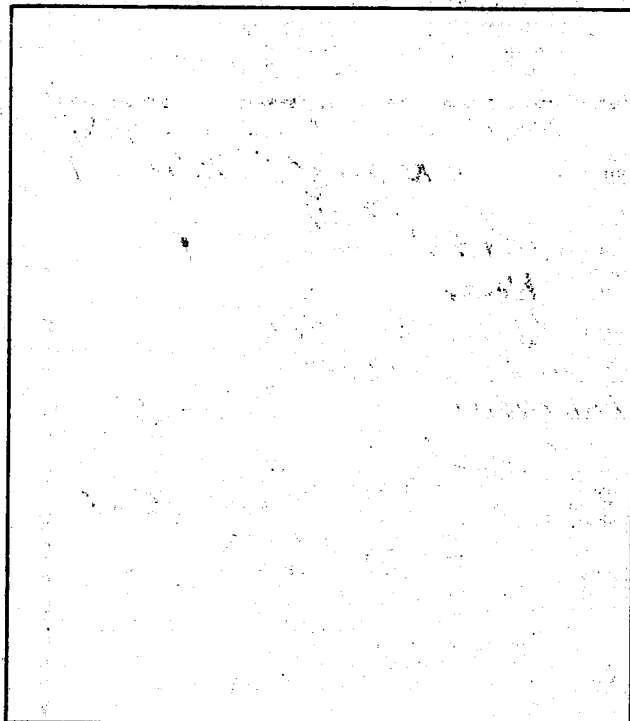

ST. ALLEY R/W

FIELD NOTES